



Service Installation Inspection Report

Subdivision: _____ Installation Date: _____

Address: _____ Lot #: _____

City: _____ Block: _____

Permit #: _____ Residential: Commercial:

Water and Sewer Service Sketch
(use this section or second page)

Sewer Profile Sketch
(use this section or second page)

Water service pressure test. Tested at minimum 100) _____ lbs. for _____ minutes with zero loss.

General Notes:

- Approved inspection record is required prior to meter installation.
- **File inspection record with District within three days of installation.**
- The District reserves the right to reject any installation report due to lack of information.
- Sketch Criteria: Show N/S/E/W, lot line, piping lengths, piping material, depths, couplings, fittings, clean-outs, curb stop box or meter pit referenced from two locations, sidewalk with “W” and “S” etch location, foundation, ground level, piping slope. See second page for detailed checklist.
- Form will not be accepted unless it is emailed or hand delivered, or otherwise, unreadable. Use this email address to send in form: frontdesk@fclwd.com

Installer Certification: (By signing, you are certifying that the installation meets all Uniform Plumbing Code requirements as published in the latest addition.)

Company Name: _____ Installer: _____

Address: _____ Installer Signature: _____

City: _____ State: _____ Zip: _____ Phone #: _____

Builder Certification: (By signing, you are approving the water and sewer services as installed.)

Company Name: _____ Superintendent: _____

Address: _____ Superintendent Signature: _____

City: _____ State: _____ Zip: _____ Phone #: _____

Email: _____

District Use Only: Date Received: _____ Approved By: _____ Entered: _____



Service Installation Inspection Report Checklist

Water and Sewer Service Sketch

Sewer Profile Sketch

- Show N/S/E/W
- Label lot lines
- Pipe length and depth
- Pipe material
- Couplings and fittings
- Clean out
- Curb Stop OR Meter Pit show distance from 2 points (i.e. property line and back of walk)



- Depth of meter pit or curb stop
- Sidewalk with "W" and "S" etch location
- Label top and bottom of foundation
- Ground level
- Depth of sewer at foundation
- Depth of sewer at sewer stub
- Pipe slope



Service Installation Inspection Report

Subdivision: Example
 Address: _____
 City: _____
 Permit #: _____

Installation Date: _____
 Lot #: _____
 Block: _____
 Residential: _____ Commercial: _____

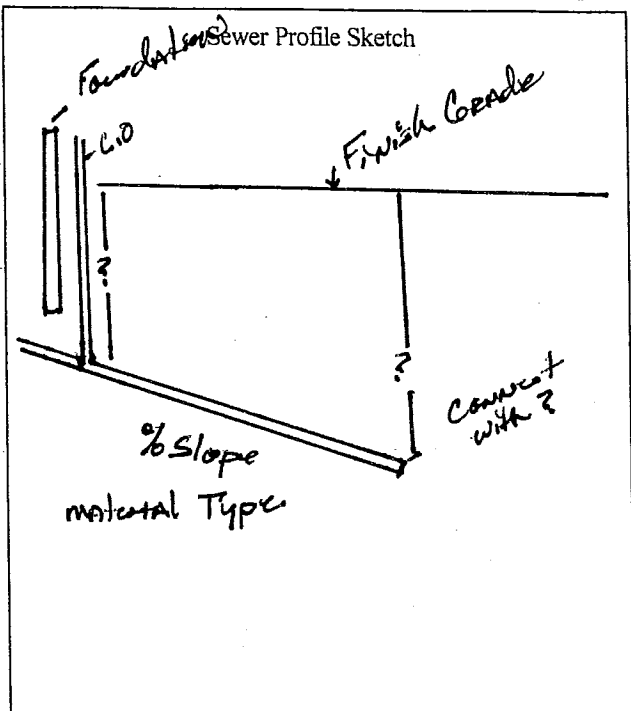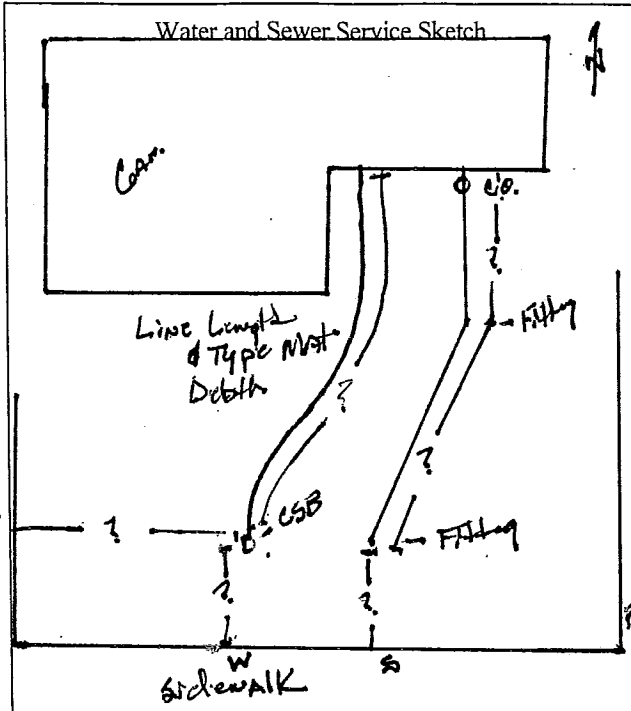

Info Needed
Info Needed

Water service pressure test. Tested at (minimum 100) _____ lbs. for _____ minutes with zero loss.

General Notes:

- Approved inspection record is required prior to meter installation.
- File inspection record with District within three days of installation.
- The District reserves the right to reject any installation report due to lack of information.
- Sketch Criteria: Show N/S/E/W, lot lines, piping lengths, piping material, depths, couplings, fittings, clean-outs, curb stop box or meter pit referenced from two locations, sidewalk with "W" and "S" etch location, foundation, ground level, piping slope.

Installer Certification: (By signing, you are certifying that the installation meets all Uniform Plumbing Code requirements as published in the latest addition.)

Company Name: _____
 Address: _____
 City: _____ State: _____ Zip: _____

Installer: _____
 Installer Signature: _____
 Phone #: _____

Builder Certification: (By signing, you are approving the water and sewer services as installed)

Company Name: _____
 Address: _____
 City: _____ State: _____ Zip: _____

Superintendent: _____
 Superintendent Signature: _____
 Phone #: _____